
ALBERTA LAND SURVEYOR'S REAL PROPERTY REPORT

The City of Calgary Planning and Development
CERTIFICATE OF COMPLIANCE
Provided that all of the information shown on this survey plan is accurate the location of the building as shown complies with the Calgary Land Use Bylaw 1P2007. This Certificate of Compliance relates only to the building location requirements of the Land Use Bylaw 1P2007 and does not relate to the requirements of any federal, provincial or other municipal legislation nor to the terms and conditions of any easement, covenant, building scheme agreement of other document affecting the building or land.
Date: May 09, 2018

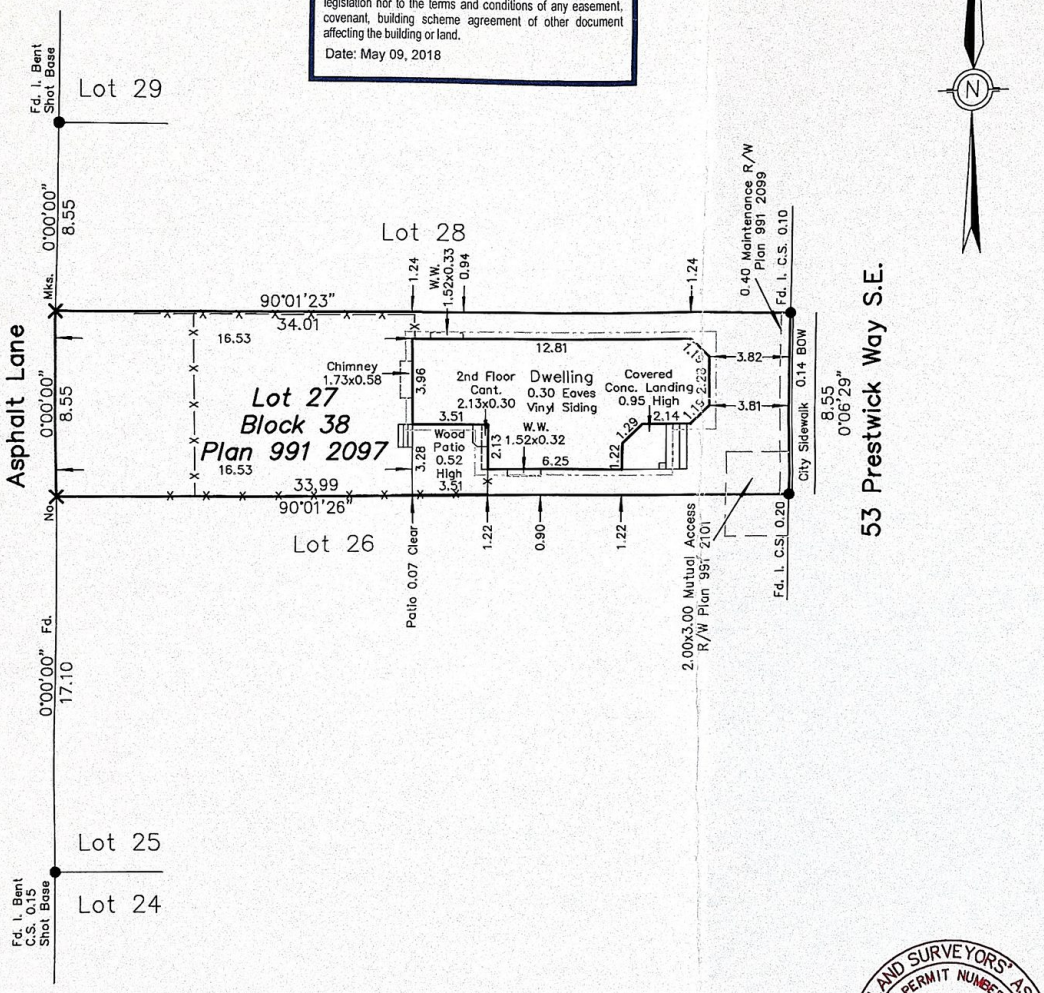

ABBREVIATIONS
A--Arc Length
Acc.--Accessory
A/C--Air Conditioner
Bldg--Building
BOC--Back of Curb
BOW--Back of Walk
Calc.--Calculated
Cant.--Cantilever
Conc.--Concrete
C.S.--Countersunk
DH--Drill Hole
Enc.--Encroaches
Fd.--Found
I.--Iron Post
I.B.--Iron Bar
M.A.--Maintenance Access
Mk.--Mark
O.D.--Overland Drainage
R--Radius
Reg.--Registration
Ret.--Retaining
R/W--Right of Way
W/O--Walkout Basement
W.W.--Window Well

NOTE:
UNLESS NOTED OTHERWISE LINES OUTSIDE OF PROPERTY ARE NOT TO SCALE.

ALBERTA LAND SURVEYORS' ASSOCIATION
PERMIT NUMBER
P 273
ARC SURVEYS LTD.

LEGAL DESCRIPTION:
Lot 27
Block 38
Plan 991 2097

MUNICIPAL ADDRESS:
53 Prestwick Way S.E.
Calgary, Alberta

DATE OF SURVEY: May 3rd, 2018.

LEGEND
Distances are in metres and decimals thereof.
Found Iron Posts are shown thus: ●
Drill Holes are shown thus: ⊠
Found Iron Bars are shown thus: ♦
Found Concrete Nails are shown thus: ▲
Calculation points are shown thus: ×
Pillars and posts are shown thus: □
Property lines are shown thus: ———
Utility Right of Ways are shown thus: — — —
Eaves are shown thus: ———
Fences are shown thus: —x—x—
All fences are within 0.2 metres of the property lines unless otherwise shown.
All eaves are measured to fascia unless otherwise shown.

PURPOSE:
This Report and attached plan have been prepared for the benefit of the Property owner, subsequent owners and any of their agents for the purpose of a land conveyance, support of a subdivision application, a mortgage application, or a submittal to the municipality for the compliance certificate, etc. Copying is permitted only for the benefit of these parties, and only if the plan remains attached. Where applicable, registered easements and utility rights of way affecting the extent of the property have been shown on the attached plan. Unless shown otherwise, property corner markers have not been placed. The attached plan should not be used to establish boundaries due to the risk of misinterpretation or measurement error by the user. The information shown on this Real Property Report reflects the status of this property as of the date of survey only. Users are encouraged to have the Real Property Report updated for future requirements.

NOTE:
Title information is based on the C. of T. 071 171 242 which was searched on the 8th day of May, 2018, and is subject to:
Utility Right of Way No.: 991 196 565
Encumbrance No.: 991 196 566
Caveat No.: 991 196 567
Restrictive Covenant No.: 991 196 568
Easement No.: 991 197 494

CERTIFICATION:
I hereby certify that this report, which includes the attached plan and related survey, was prepared and performed under my personal supervision and in accordance with the Alberta Land Surveyors' Association Manual of Standard Practice and supplements thereto. Accordingly within those standards and as of the date of this Report, I am of the opinion that:
1. the Plan illustrates the boundaries of the Property, the improvements as defined in Part D, Section 8.5 of the Alberta Land Surveyors' Association's Manual of Standard Practice, registered easements, and rights-of-way affecting the extent of the title to the property;
2. the improvements are entirely within the boundaries of the Property
3. no visible encroachments exist on the Property from any improvements situated on an adjoining property
4. no visible encroachments exist on registered easements or rights-of-way affecting the extent of the Property
5. unless otherwise specified, the dimensions shown relate to the distances from property boundaries to the foundation walls of buildings at the date of survey.

Dated at Calgary, Alberta on this 9th day of May, 2018.

Jerrad Gereln, A.L.S.
This document is not valid unless it bears an original or digital signature in blue ink and an Arc Surveys Ltd. permit stamp in red ink.

© Copyright Arc Surveys Ltd. 2018

Arc Surveys Ltd.
201B 38th Avenue NE, Calgary, AB T2E 2M3
Ph.: 403-277-1272 www.arcsurveys.ca
Fax: 403-277-1275 info@arcsurveys.ca

Surveyed: SC | Drawn: YH | Scale: 1:250 (0m 2.5 5 10) | File No.: 181031